GENERAL CONSTRUCTION NOTES: Floors: All works to be carried out in accordance with the relevant parts of SANS10400: regulations. No additional floor area added to the existing building coverage. Structural work to professional engineers details. All new load bearing structures on the existing floor slabs must be confirmed by the structural engineer. No new excavations or foundations. SANS 10400part 4.14 and SANS 10177. All work carried out are within the existing building structure. **Demolition Works:** All demolition works to be carried out in accordance with SANS10400: Part E. Demolition of walls or other structures must be verified by the structural engineer prior to commencing any work on site. **Brickwork:** Masonry walls to comply with SANS 10400: Part K.230 walls tied to every 3rd course. Wall ties to be staggered. 110mm brick wall reinforced with 75mm wide reinforcing one row to Windows & Doors: every 3 courses in height. No new external windows. Provide brick force to every course above windows, doors and Internal windows & doors, refer to the window schedule. openings. 10mm impregnated soft-board at all junctions between brickwork & Glazing installation to comply with SANS 10400: Part N. All aluminum frame sizes to comply with AAAMSA standards. concrete, as well as between old and new brickwork. Joints to be Refer to shopfront & window schedule. filled with polysulphide sealant. Glazing & aluminum compliance certificate to be provided by the 'V' joints to be provided at the junction between brickwork and manufacturer / installer. concrete. Ruled 'v' joints between existing and new brickwork. Precast concrete lintels over all doors, windows and openings to Signage: No New external signage. comply with SANS 10400 Part K 4.2.9. table 20. All brickwork to be plastered & painted with SABS approved PVA external quality paints. **Ventilation Note:** New brickwork to be built onto the existing floor surface beds as per the eng's details. Artificial ventilation as per mechanical engineers specifications. Extraction to ablutions and kitchen at a rate of 20 air changes Partition Walls: per hour as per the ex. system. Offices and open plan areas to have fresh air introduced at 7.5Lt New partitions to be installed as indicated. per second per person at a velocity not exceeding 0.5m/s. Partition Walls to comply with SANS10400: Part T 4.9 Fire Partition Walls: (Perimeter or division walls) 15mm thick Jumbo Fire Wall Drywall boards fixed to internal studs to achieve a 90mm partition wall with a 120 minute fire rating as per SABS 0177: Parts -1981. Partition boards must be extended to the u/s of the roof sheeting. Internal Partition Walls: 12mm Standard Jumbo Drywall (or similar approved) fixed to internal studs to achieve a 90mm partition wall with a 30-minute fire rating as per SABS 0177: Parts-1981. Partition walls to be installed under the manufacturer's specifications. Partition compliance certificate to be provided by the manufacturer / installer. Existing adj. building ERF 10 ERF 7 Boundary Line 118,195m Ex. P.C fence 98.200 Ex. MH Ex. septic tank 25 26 27 28 29 Ex.SWS Ex. position of Ex. cellphone tower generator. Ex. carport. Ex. paving 33,854m

Ex floor slabs. No new Floor slabs added.

- New floor tiles to be installed as per the manufacturers specifications.
 - Vinyl Floor Tiles to have a classification 4 fire rating and comply with SANS 10400 part 4.14 and SANS 10177. Carpet Tiles to have a classification 4 fire rating and comply with

 New acoustic ceiling tiles on suspended powder coated tee grid & plasterboard ceilings, installed as per the manufacturer's

- specifications. Ceiling height 2700mm above ffl. Min 2400mm high.
 - Shadow-line cornice at junction between wall and ceilings. Ceiling compliance certificate to be provided by the
 - manufacturer / installer. Ceiling tiles to have a non-combustible fire rating and comply with SANS 10400 Part T 4.13 and SANS 10177.

No new external or internal drainage pipes.

Drainage:

- All SANWARE to be replaced with new, no additional drainage added. Only replace ex. San-ware were necessary.
 - No addational area, therefore no additional sanitary ware required.

Fire Safety:

No new external signage. Signage to comply with SANS 10400: Part S4.2. and SANS 10400: Part T4.29.

Stormwater:

No new Stormwater pipes

Energy Efficiency:

External glazing is less than 20% of the total building area, therefore XA submission is not required.

Public safety:

Existing adj. building

Ex. P.C fence

Ex.G Ex. G

Ex. sewer Line Ex. MH

⊚Ex.G

GENERAL NOTES:

No new ramps.

No new changes in floor levels.

It is the contractors responsibility to make sure that all of the SANS requirements are adhered too, during construction. The contractor is to comply with the site operations

- requirements in terms of SANS 10400: Part F. No dimensions to be scaled or scanned from drawings. Figured dimensions are to be used at all times. All dimensions to be
- checked on site Contractor is responsible for correct setting out of the buildings, all internal and external walls. Contractor to verify all levels, heights and dimensions on site
- and to check the same against the drawings before putting any work in hand. Any errors, discrepancies or omissions to be reported to the architect immediately by the contractor.

99.500



SHEET:

KWAZULU-NATAL AMAFA

This drawing is the copyright and the

(Pty) LTD and MUST NOT be retained.


copied, distributed or used without the


property of Kuppan Architectural Designs

written approval of the company's director.

CASE: 25413

10 July 2025

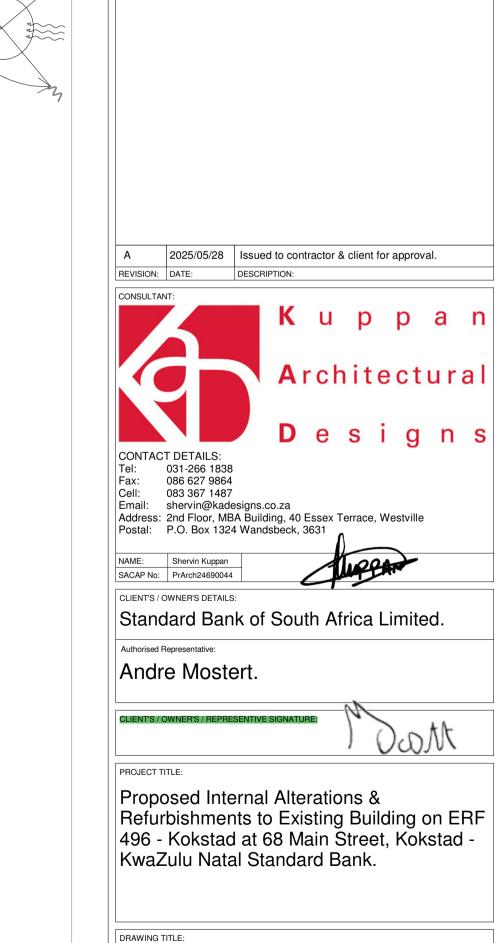

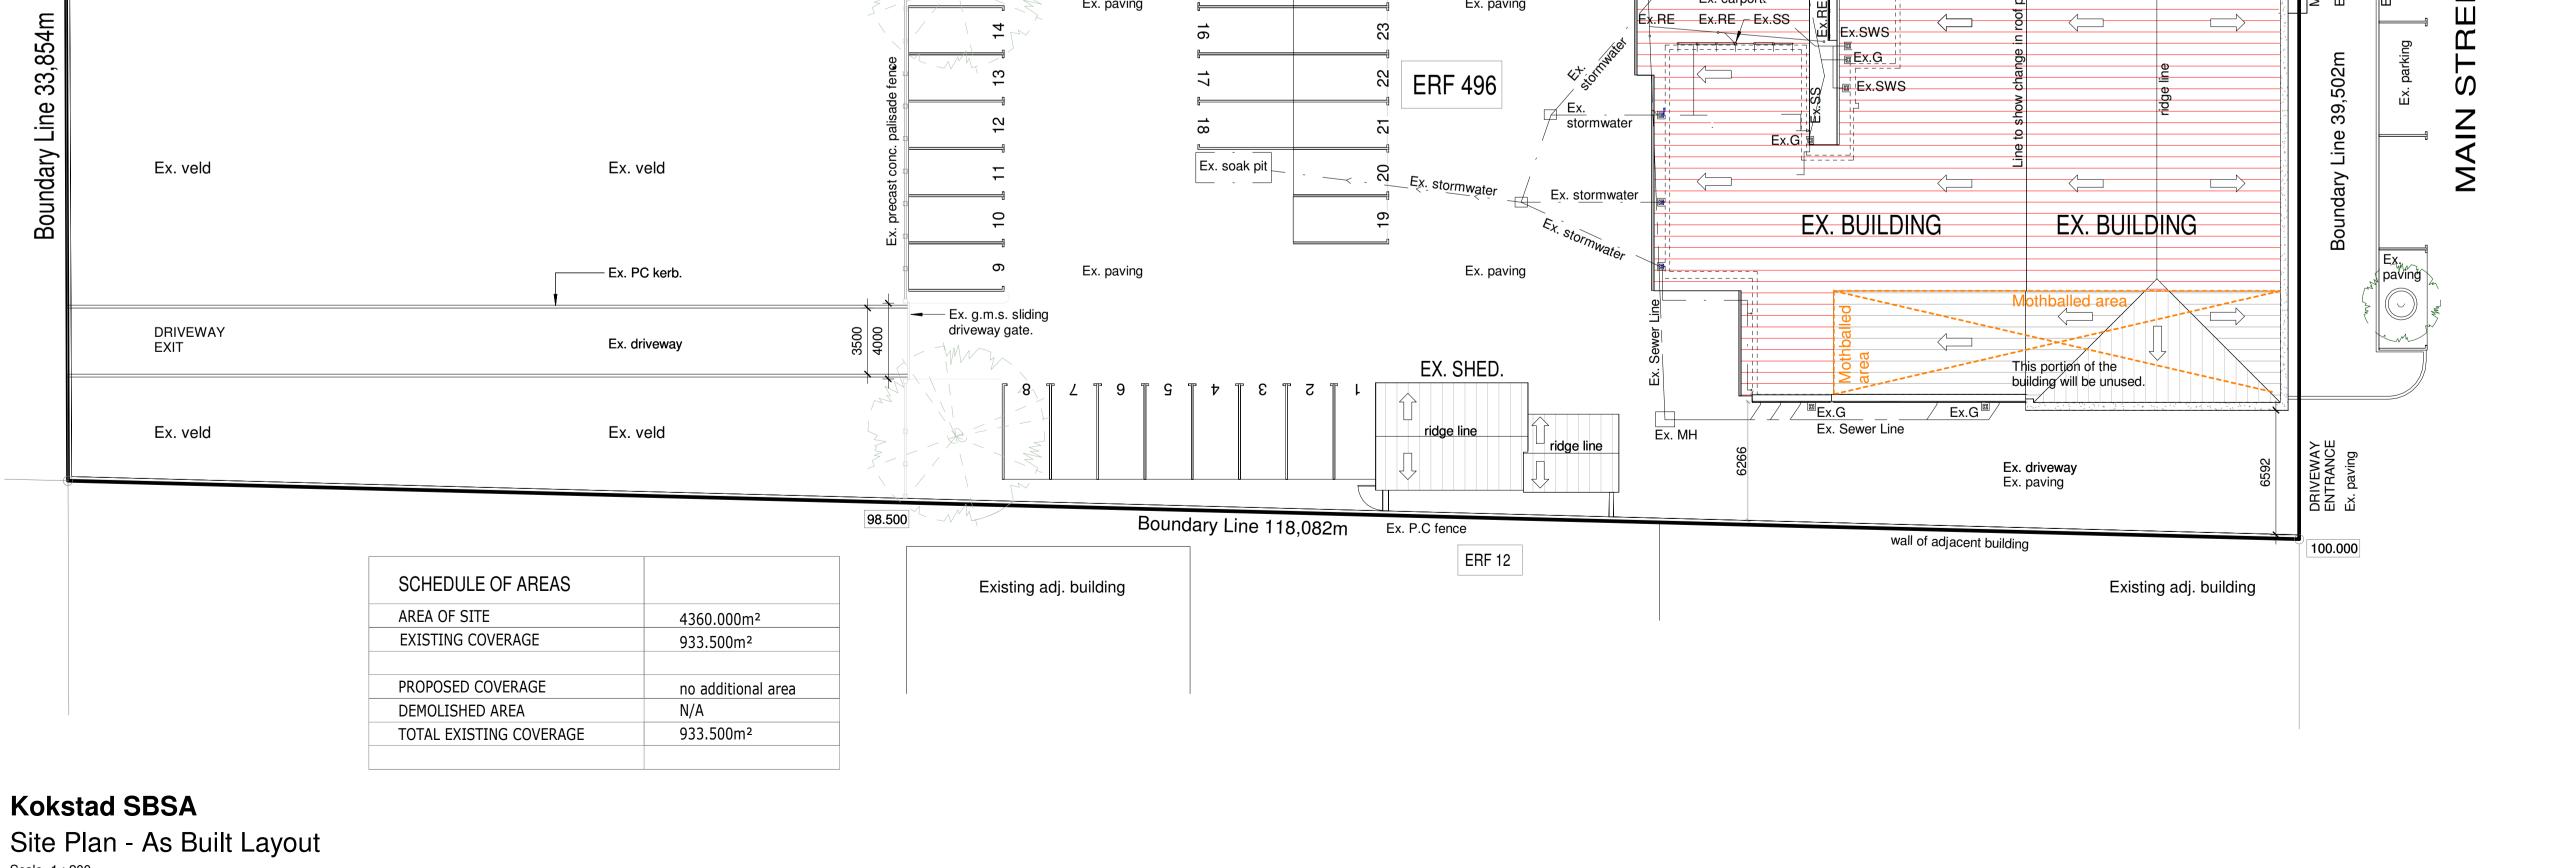

ERF 6

ERF 5

Site Plan - As Built Layout Scale 1:200

191_SD1000

(A0) 1:200

Site Plan

S.S.B.Roy

Internal Alterations and Refurbishments to

Existing Building: for Standard Bank: